



No.	Revision/Issue	Date
1.	Per as-built	11/01/07

Project Name and Address

Project Name and Address


  
 Challenger Technologies, L.L.C.
   
 PO Box 4217
   
 Jackson, MI 49204-4217

Project: BAS-20-16 Sheet:
   
 Date: 09-02-04 RAN DAT1.1
   
 Scale: NTS Size: B

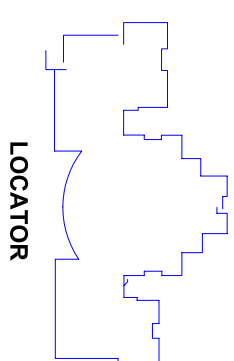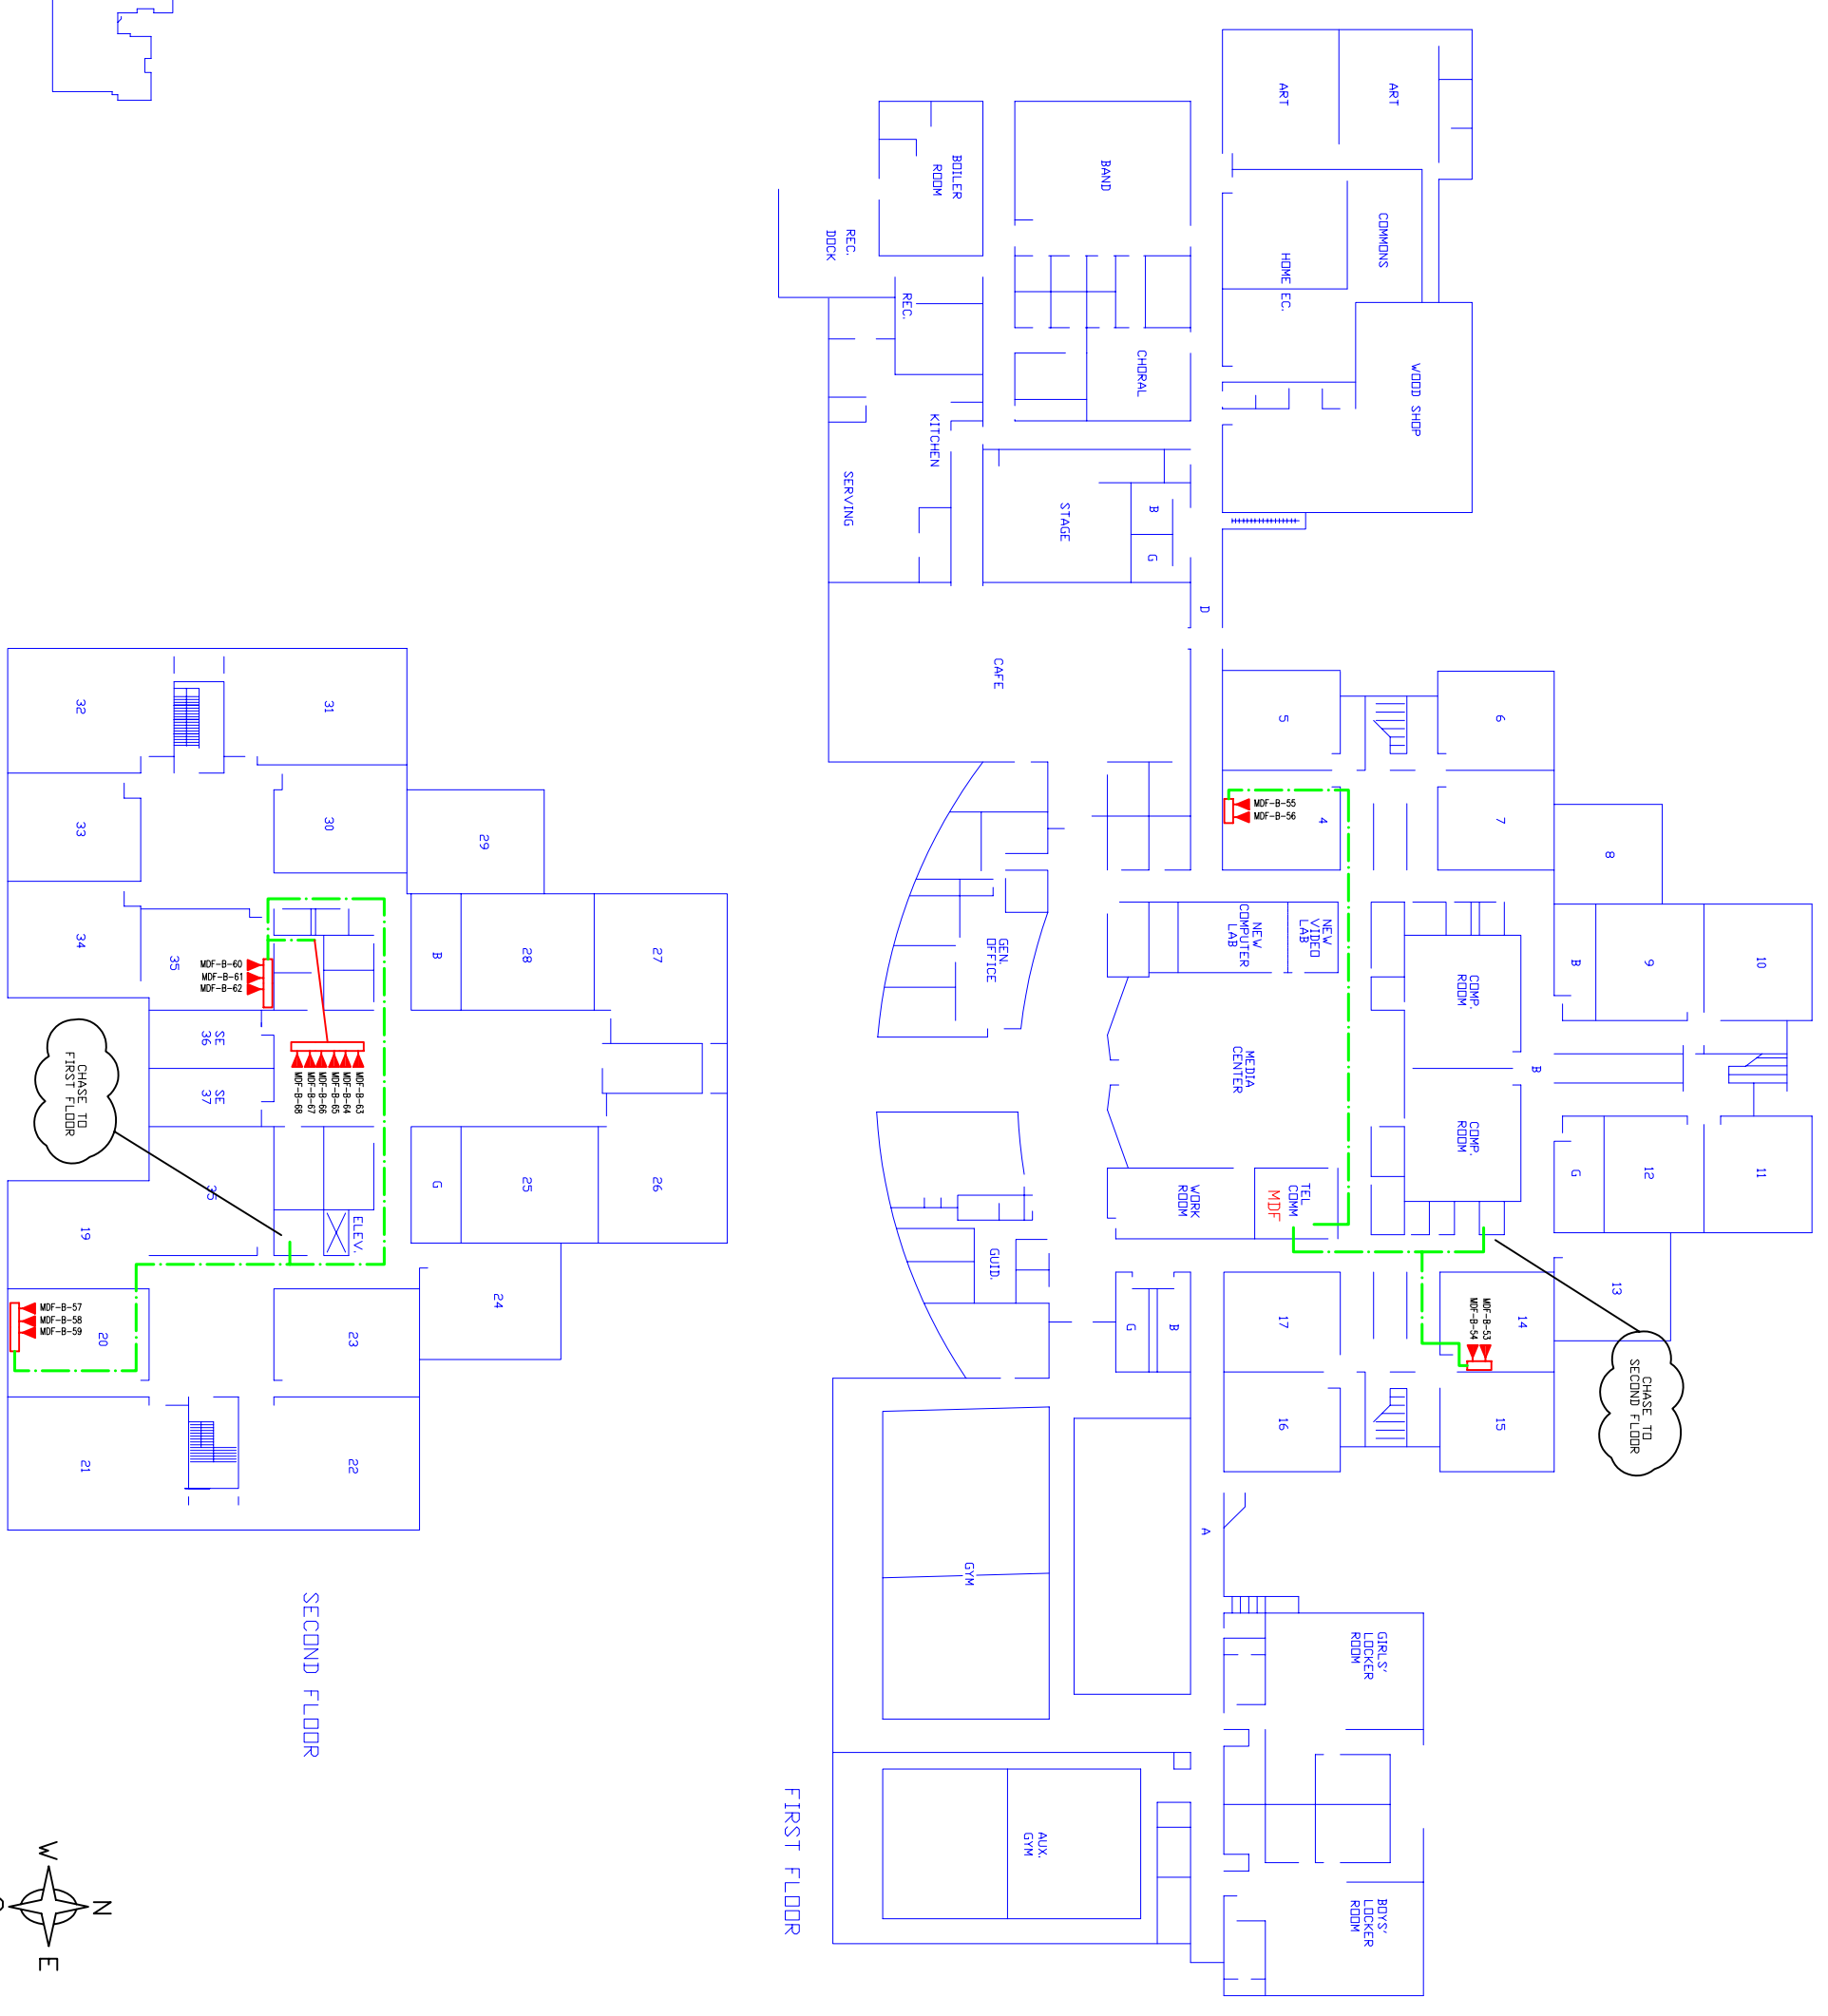

LOCATOR

SECOND FLOOR

FIRST FLOOR

